

R.S.C. Ref No. EC0046251





SURVEYOR'S CERTIFICATION

" I, Shane Geoffrey Long
 being a Consulting Surveyor and duly authorised representative of: -
BMD CONSTRUCTIONS Pty. Ltd.

hereby:-

- # certify the information contained in this drawing is an accurate "as constructed" representation of the works;
- # accept responsibility for the "as constructed" information contained in this drawing; and
- # acknowledge the "as constructed" information contained in the drawing may be relied on by the Redland Shire Council and others.

Certification for Stage 3 by SL on 09-11-2009
 For: S. G. Long and Associates (S2292)

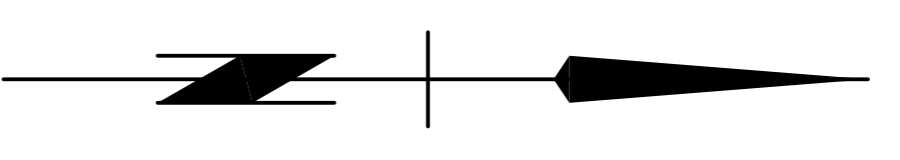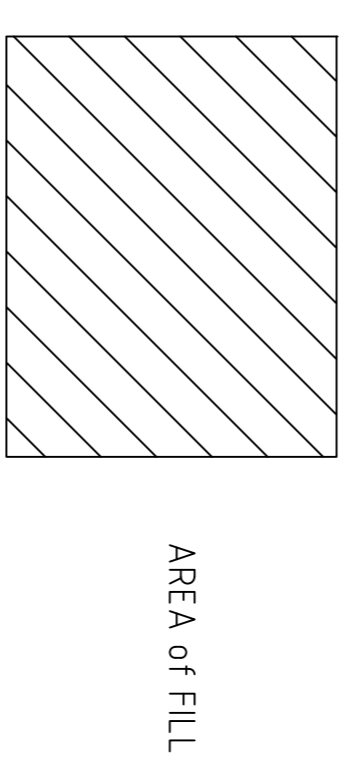

A		1109		PRELIMINARY ISSUE		CADFILE:		SUNSTATE ENGINEERING SURVEYS		SURVEYED		B.H.		10.09		No. 1 OF		BMD CONSTRUCTIONS Pty.Ltd.		DRAWING No.		REV.	
								Unit 2/4, Stone Street, CLONTARF, Q. 4019		B.H.		B.W.		1109		1 SHEETS		363 MONTAGUE RD.		CB-0624-ACR		A	
								Phone (07) 3283 1611 Fax: (07) 3283 7633 Mobile: 0411 171 322		DRAWN		B.W.		1109		1 SHEETS		WEST END, QLD 4101.		AS CONSTRUCTED RELIEF & FILL		SCALE: 1 : 500	
								Email: sursur@bdgpondnet.au		CHECKED		A.H.D.		1 SHEETS		1 SHEETS				SOVEREIGN HEIGHTS ESTATE 6 STAGE 3			
								ABN: 33 011 008 521		B.H.		10.09		1 OF		1 SHEETS		KING ST. THORNLANDS					